


LEVEL 1



RF BLDG. 420

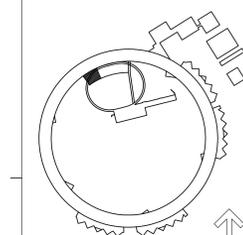


PROJECT TITLE  
ADVANCED PHOTON SOURCE  
CONVENTIONAL FACILITIES  
PROJECT NO. ANL 01907 KNIGHT 4900  
DOCUMENT TITLE  
PROCESS PIPING-WEST  
P107

DRAWN BY A/E-	PROJECT MANAGER A/E-	BINDING ORDER
DESIGNED BY A/E-	PROJECT MANAGER ANL-	FACILITY NO(S)
CHECKED BY A/E-	ANL APPROVAL DATE	
MSTR. DISK ID VOL. NO.	FILE NAME	STATUS
	Filename	

FACILITY DOCUMENT NUMBER  
JO 411-001WA A000  
WBS DOCUMENT NUMBER  
7103 001 AA

PACKAGE: ????????

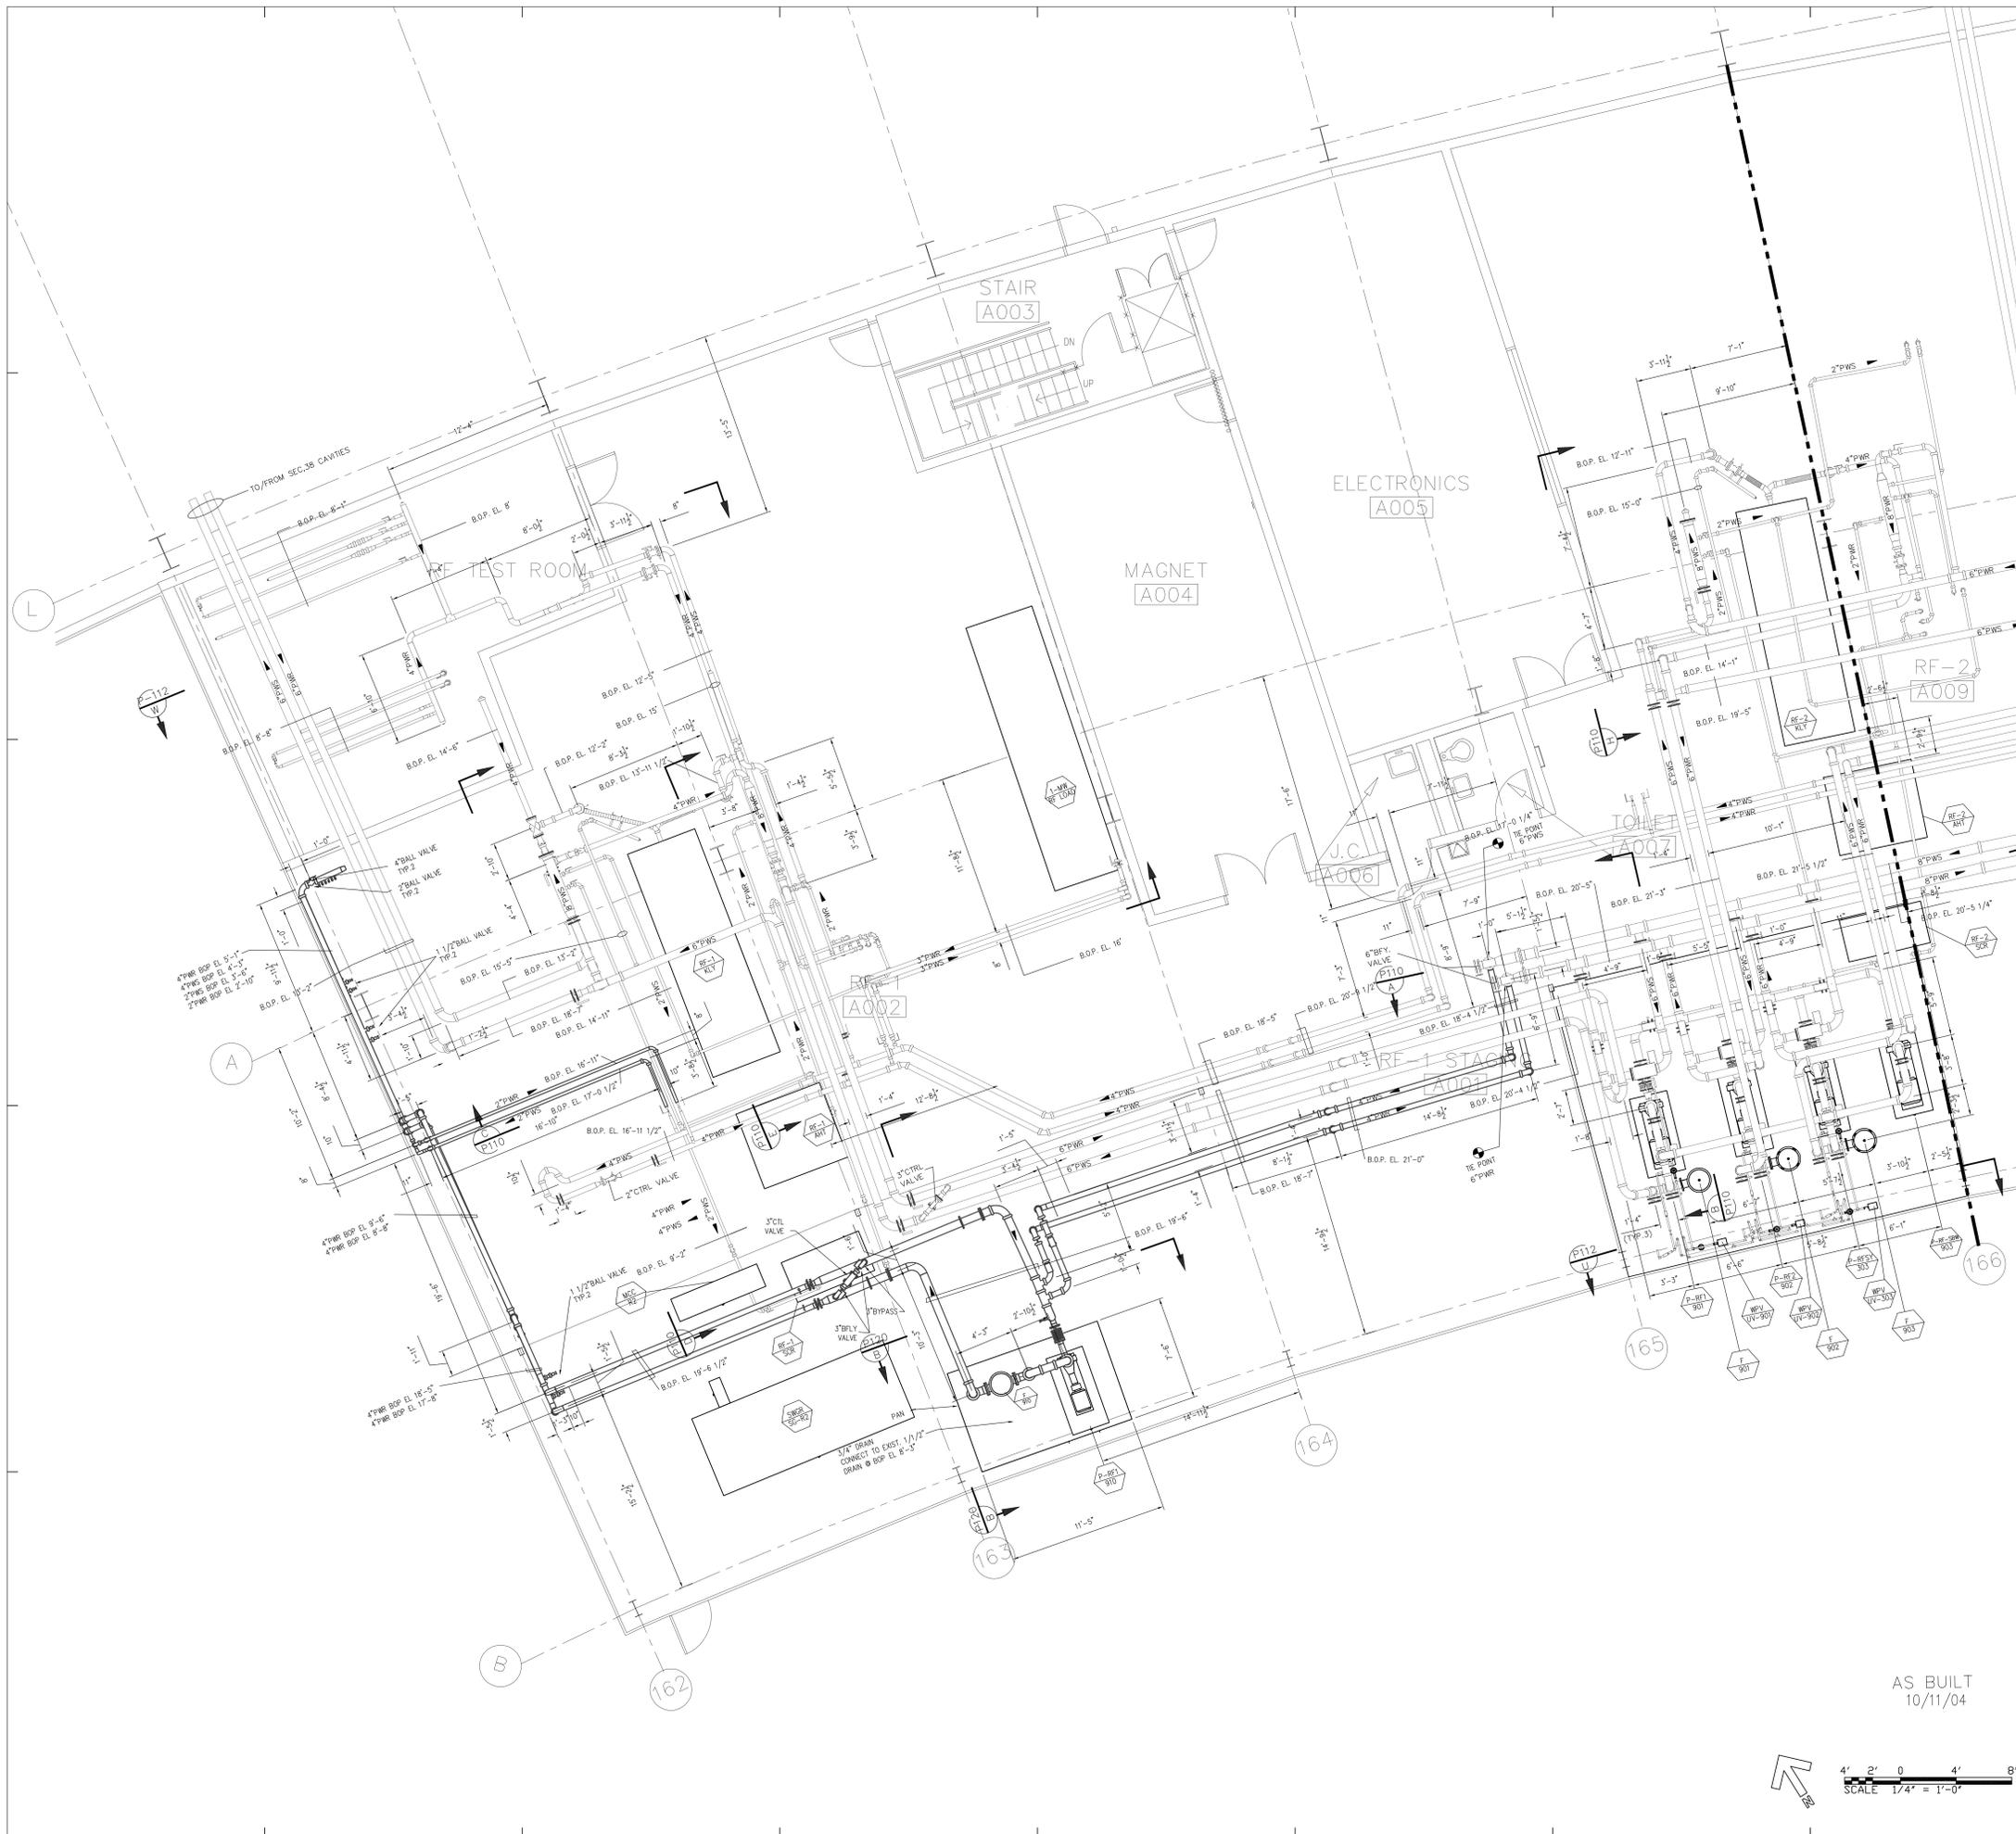

AS BUILT  
10/11/04



SCALE 1/4" = 1'-0"

PACKAGE  
Title1  
Title2  
USERNAME

AREA1 AREA3  
Filename  
Date \_ Time

PACKAGE  
Title1  
Title2  
USERNAME

AREA1 AREA3  
Filename  
Date \_ Time