BUILDING 411/412 ALARM POINTS

FIELD MATERIAL

DEVICE TAG	QTY	CODE NUMBER	DESCRIPTION
PS-1-PS-3	3	P47GA-9C	STEAM PRESSURE CONTROL
PS-4-PS-5	2	P74FA-5C	DIFFERENTIAL PRES CONTROL
R-1-R-4	4	8828-UL-120	CONTROL RELAY 120 VAC-1DCC
TS-2	1	A19AAC-9C	GENL PURPOSE TEMP CONTROL
ACC	1	VZ-1080-2	S.S. WELL

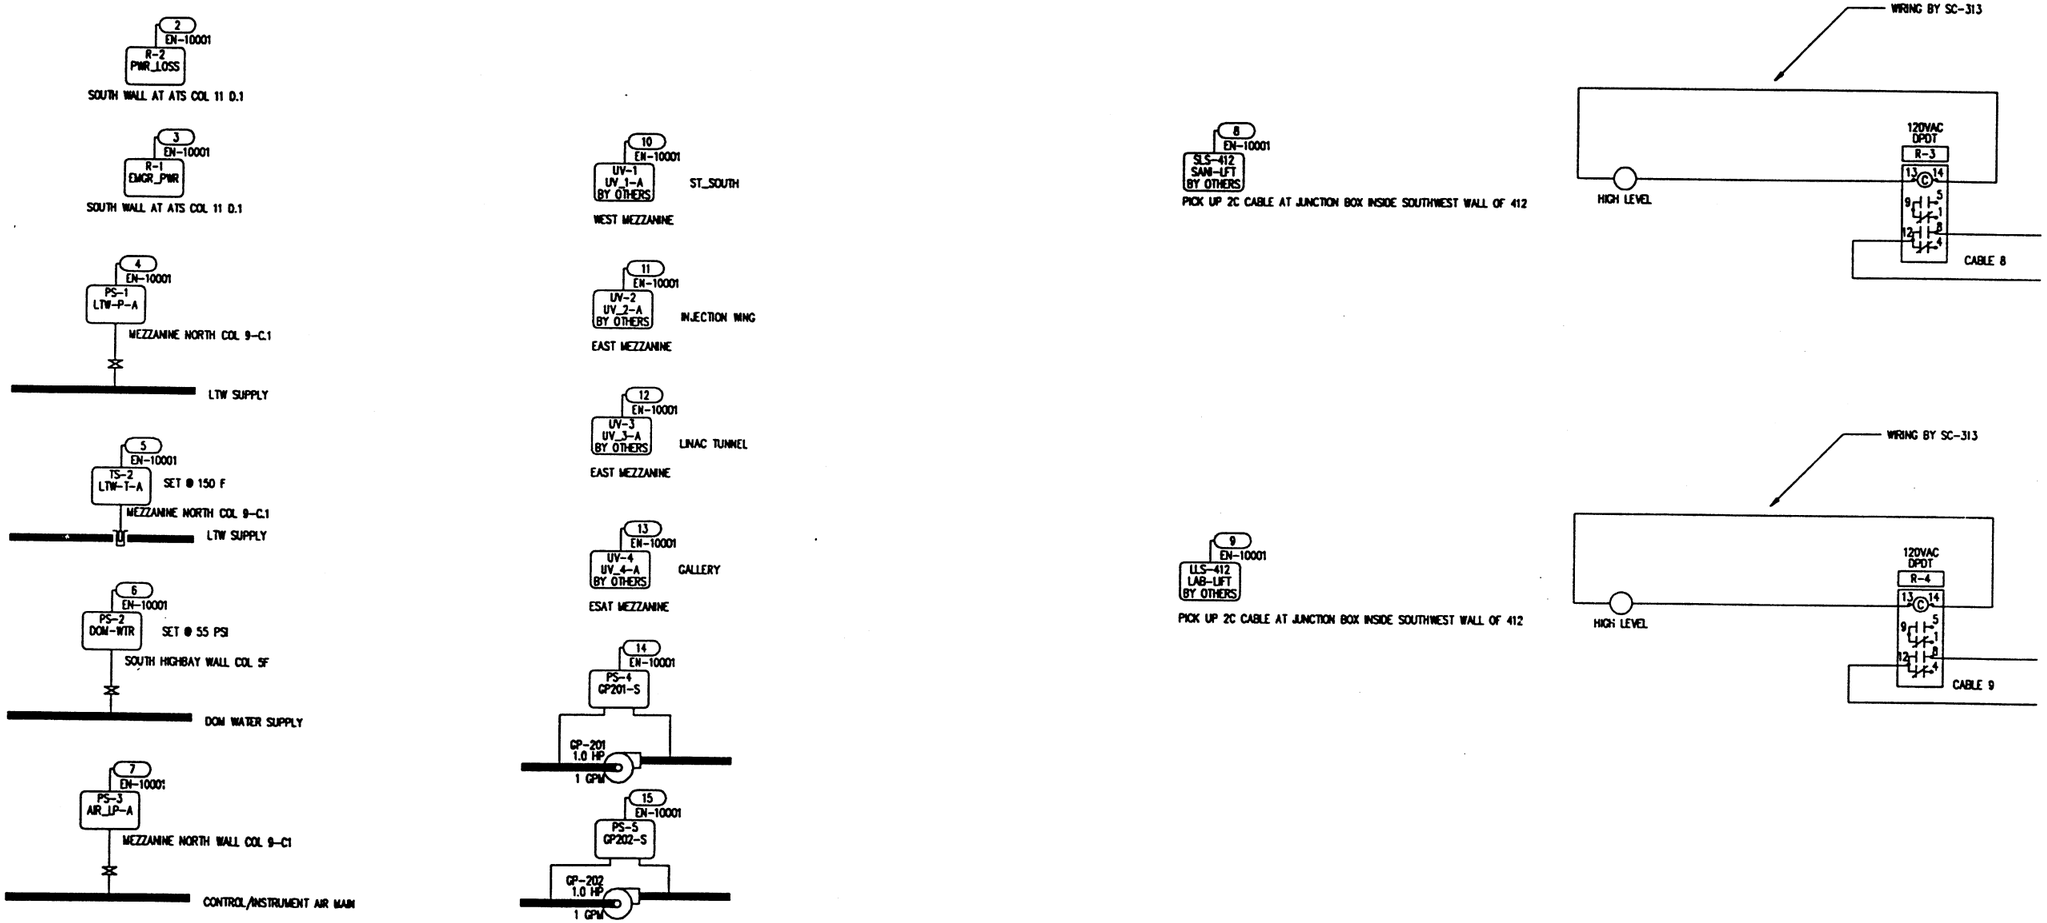

DRAWING TITLE Buildings 411/412 ICS Alarm Points				FILE: 411_ALM DCODE: 19930701.1826	
		1	REVISE LITF STA	07/01/93	SF
			AS BUILTS	07/01/93	DCS
REFERENCE DRAWING	NO.	REVISION-LOCATION		ECN DATE	BY
SALES ENGR JP / PROJECT MGR SF / APPL. ENGR DCS	DRAWN BY SF DATE 11/10/92			APPROVED BY DATE	
PROJECT The Argonne National Labs Advanced Photon Source Campus 9700 Cass Avenue South Argonne, IL 60439	JOHNSON CONTROLS Systems & Services Division	3007 MALMO ROAD ARLINGTON HEIGHTS ILLINOIS 60005 708/364-1500 Main 708/806-4438 Eng		CONTRACT NUMBER 91390-0009	
				DRAWING NUMBER 91-9-B-09B	

COPYRIGHT JOHNSON CONTROLS, INC.1993